


105F-9
New Corporate Bond Trading Room

DRAWING NUMBER
105F-9

DRAWING NUMBER
105F-9

DRAWING NUMBER
105F-9

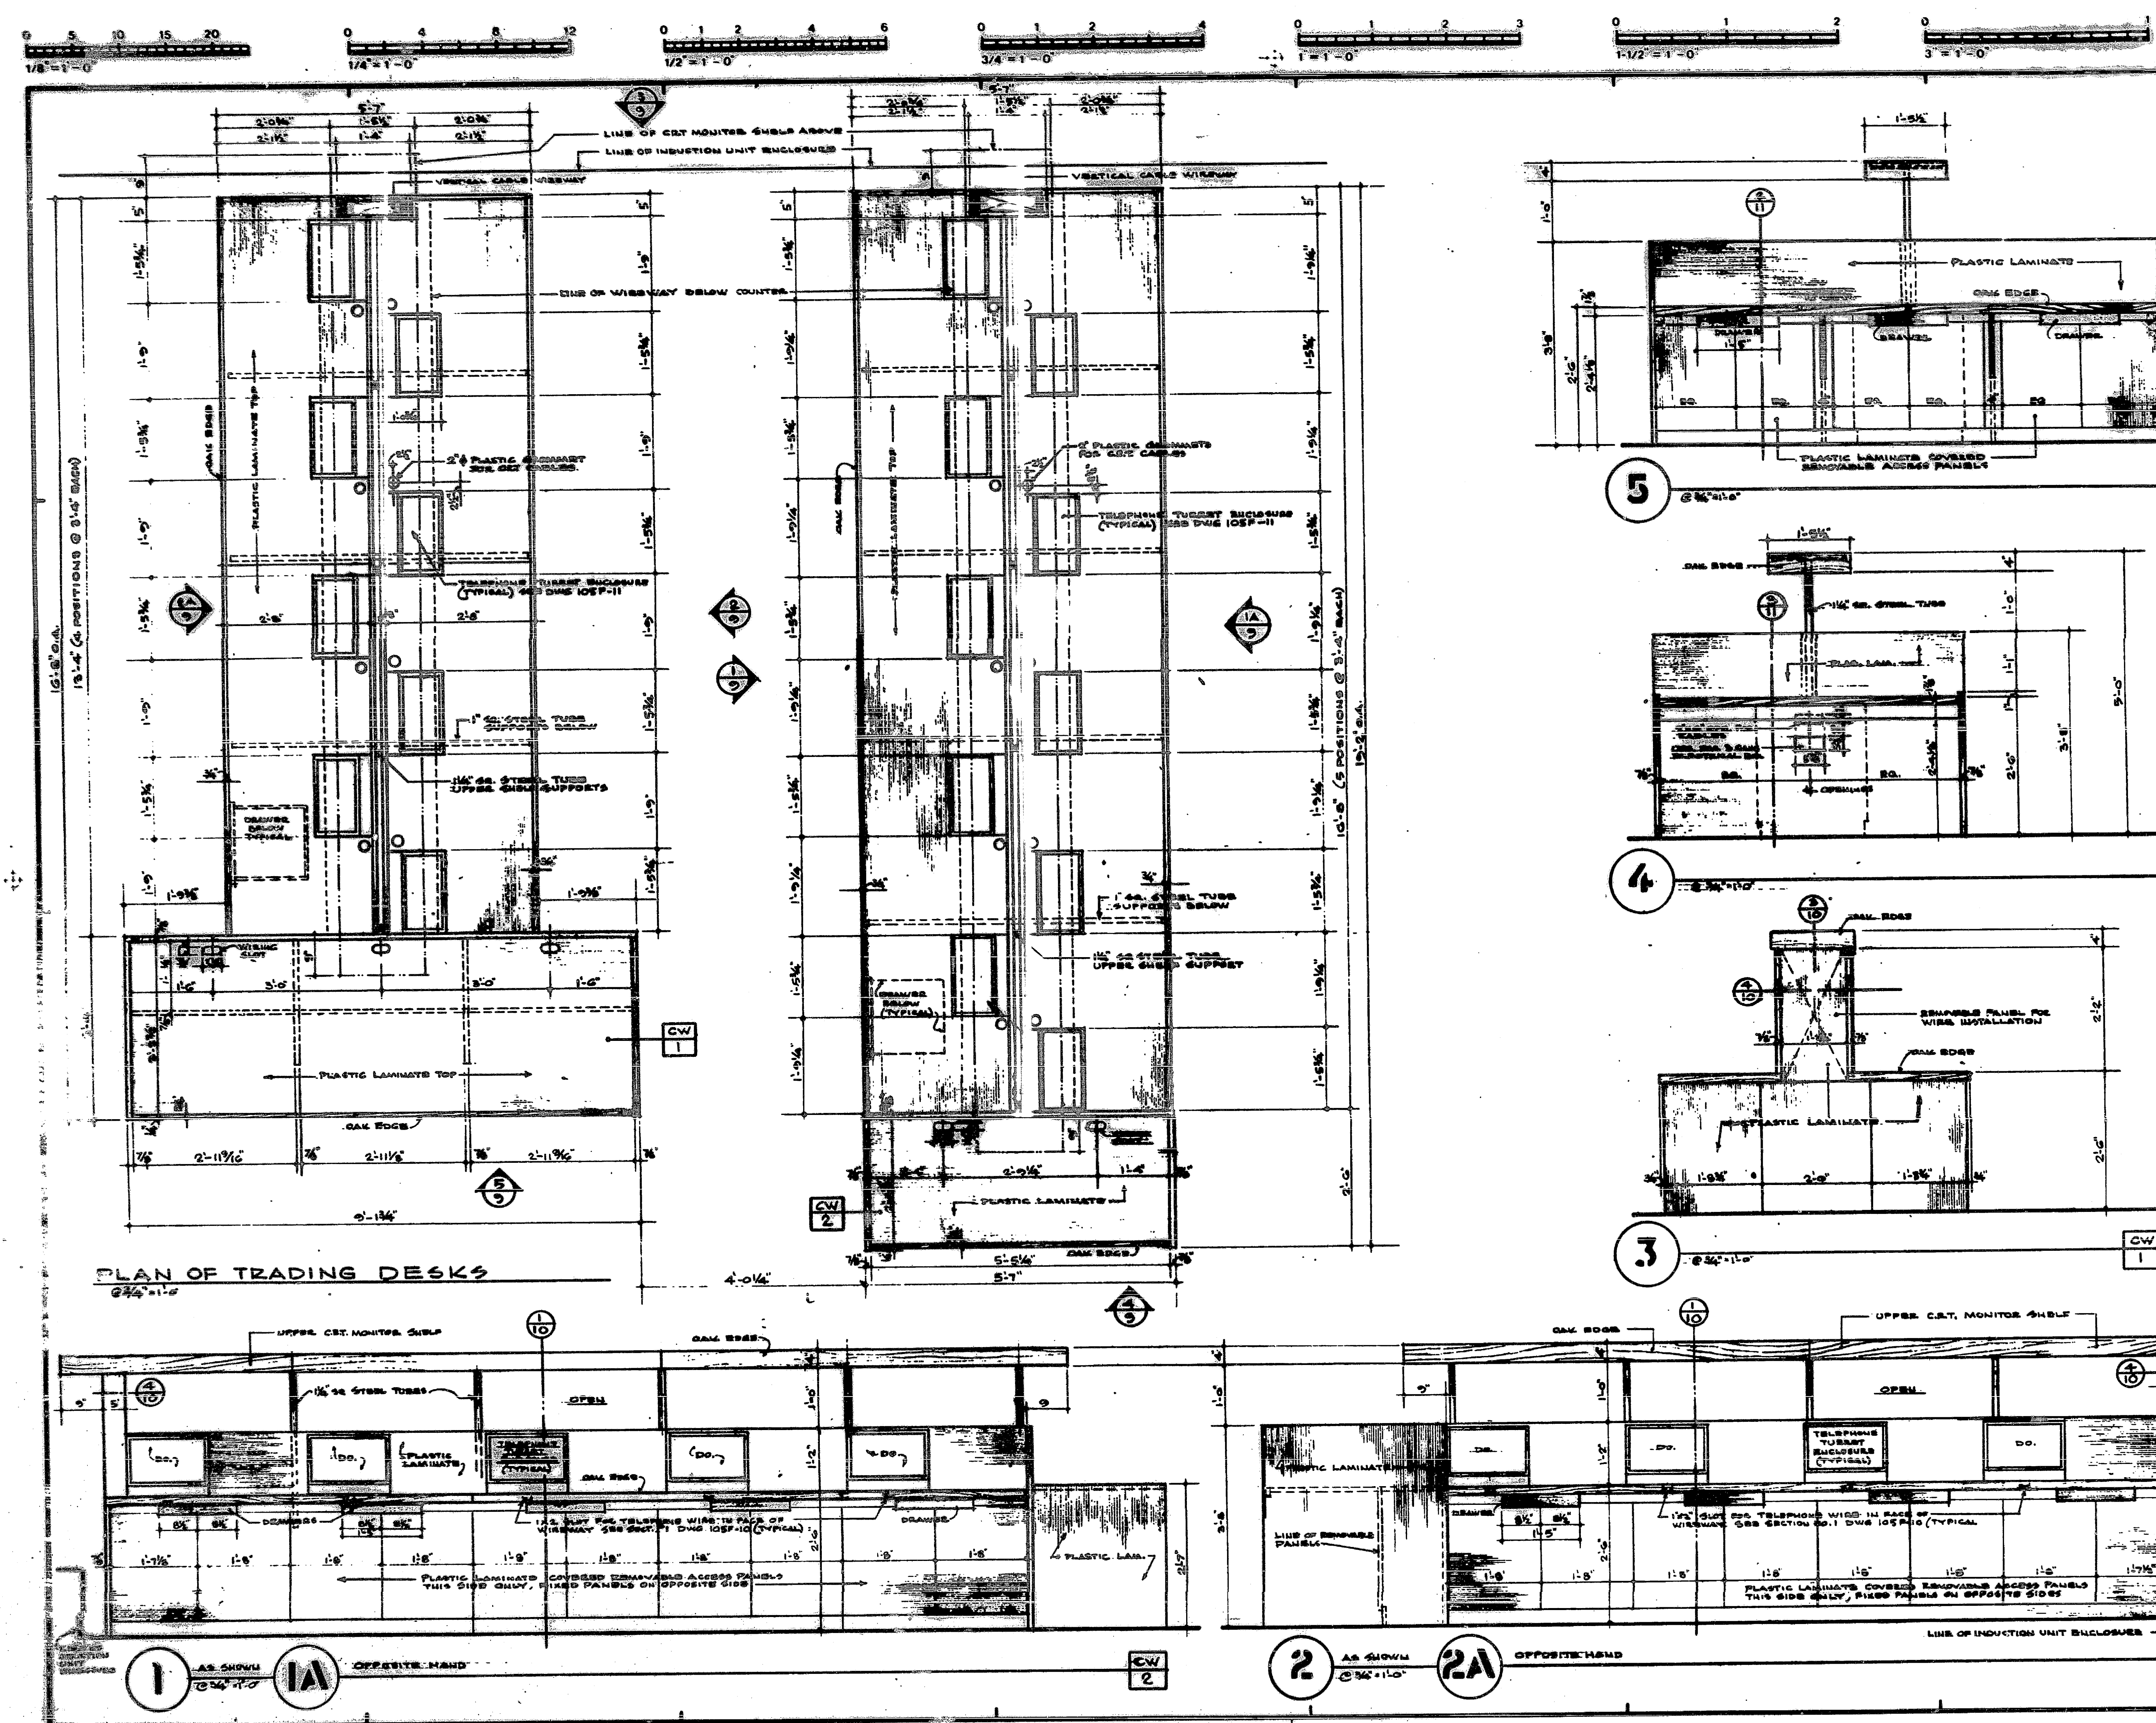

IF THIS DRAWING IS NOT 24"x36" IT IS A REDUCED PRINT SCALE ACCORDINGLY

CFA

CHARLES D. FLAYMAN ASSOCIATES INC.
880 CANAL STREET STAMFORD, CT. 06902
203 348-4300

DATE	ISSUED TO	PR.	TR.
12-7-84	POST AUTHORITY FOR APPROVAL C.A.S.C. REG. NO. 1057A C.F.C. REG. NO. 1057A	10	1
1-18-85	POST AUTHORITY FOR APPROVAL C.A.S.C. REG. NO. 1057A C.F.C. REG. NO. 1057A	10	1
5-9-85	POST AUTHORITY FOR APPROVAL C.A.S.C. REG. NO. 1057A C.F.C. REG. NO. 1057A	10	1

PHASE

F

TAA NO. 3104
AS BUILT DWG.
5-1-85

STATE OF NEW YORK
JULY 1, 1985
REGISTERED PROFESSIONAL ENGINEER

AS-BUILT DRAWING

DATE 5/12/86

INSPECTOR *[Signature]*

NO.	DATE	REVISION	BY
1			

**CANTOR, FITZGERALD
SECURITIES CORP.**
105th FLOOR
ONE WORLD TRADECENTER, NEW YORK, N.Y.

**NEW CORPORATE BOND
TRADING ROOM
PLANS & ELEVATIONS
OF TRADING DESKS**

PROJECT NO. 1357A
SCALE 3/4"=1'-0"
DRAWN BY J.F.P.
CHECKED BY
DATE 12-6-84

DRAWING NO.
105F
9